The Examiner's amendments have been approved by the Applicant.

The drawing changes are also approved: the reference numeral "10" has been added to FIGURES 1 and 8; reference numerals "64", "70" and "72" have been added to FIGURE 2.

A red-lined drawing showing the changes is attached, along with a complete set of formal, corrected drawings.

Respectfully submitted,

G.O Los

Albert O. Cota Agent of Record

Registration No. 29,291

(818) 368-4332

RED-LINED DRAWINGS

1/7

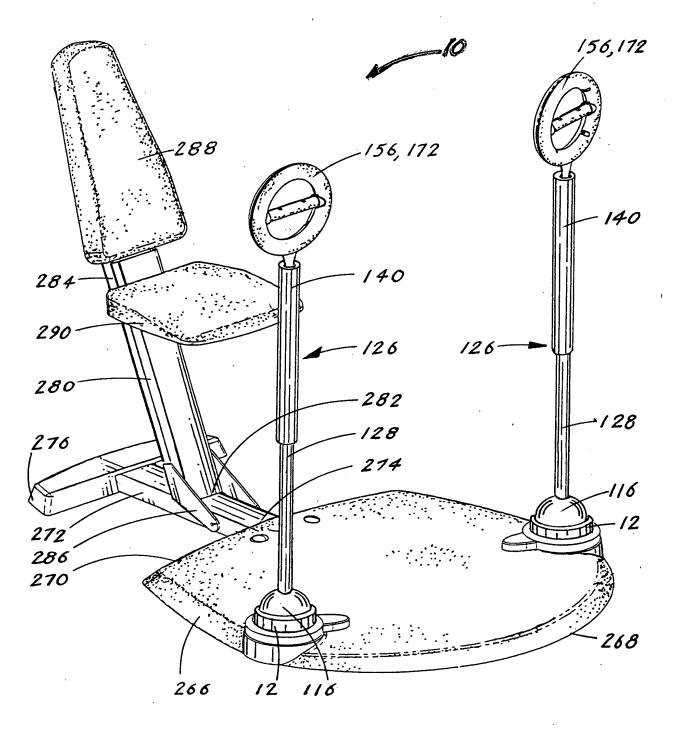
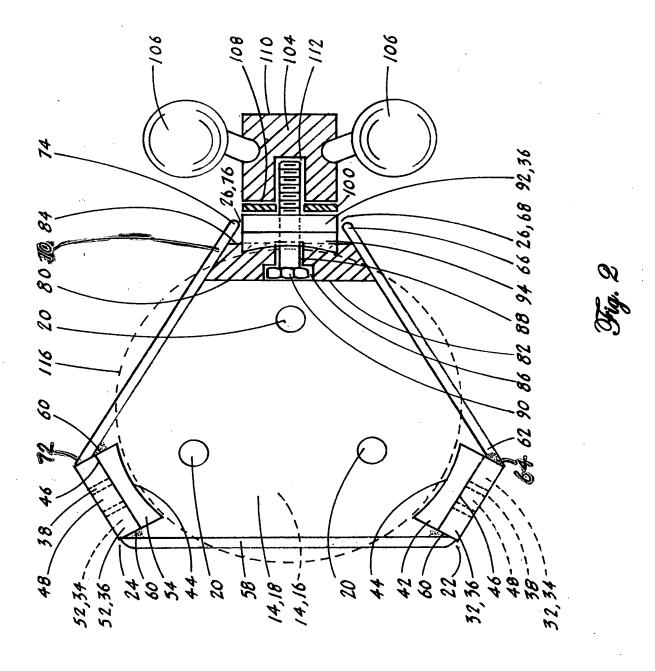


Fig. 1



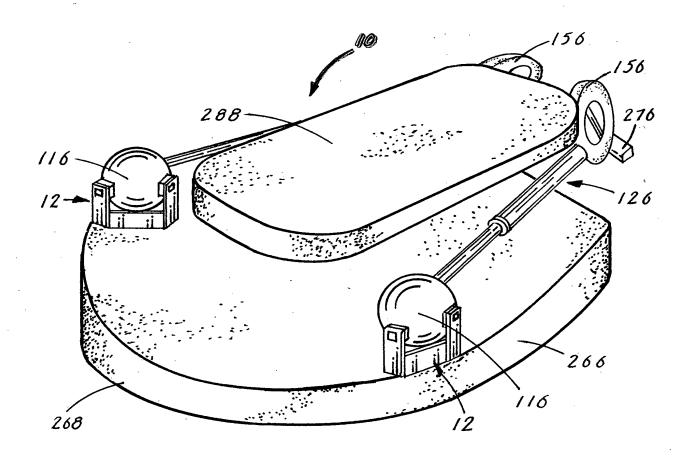


Fig. 8